


EXIT
231

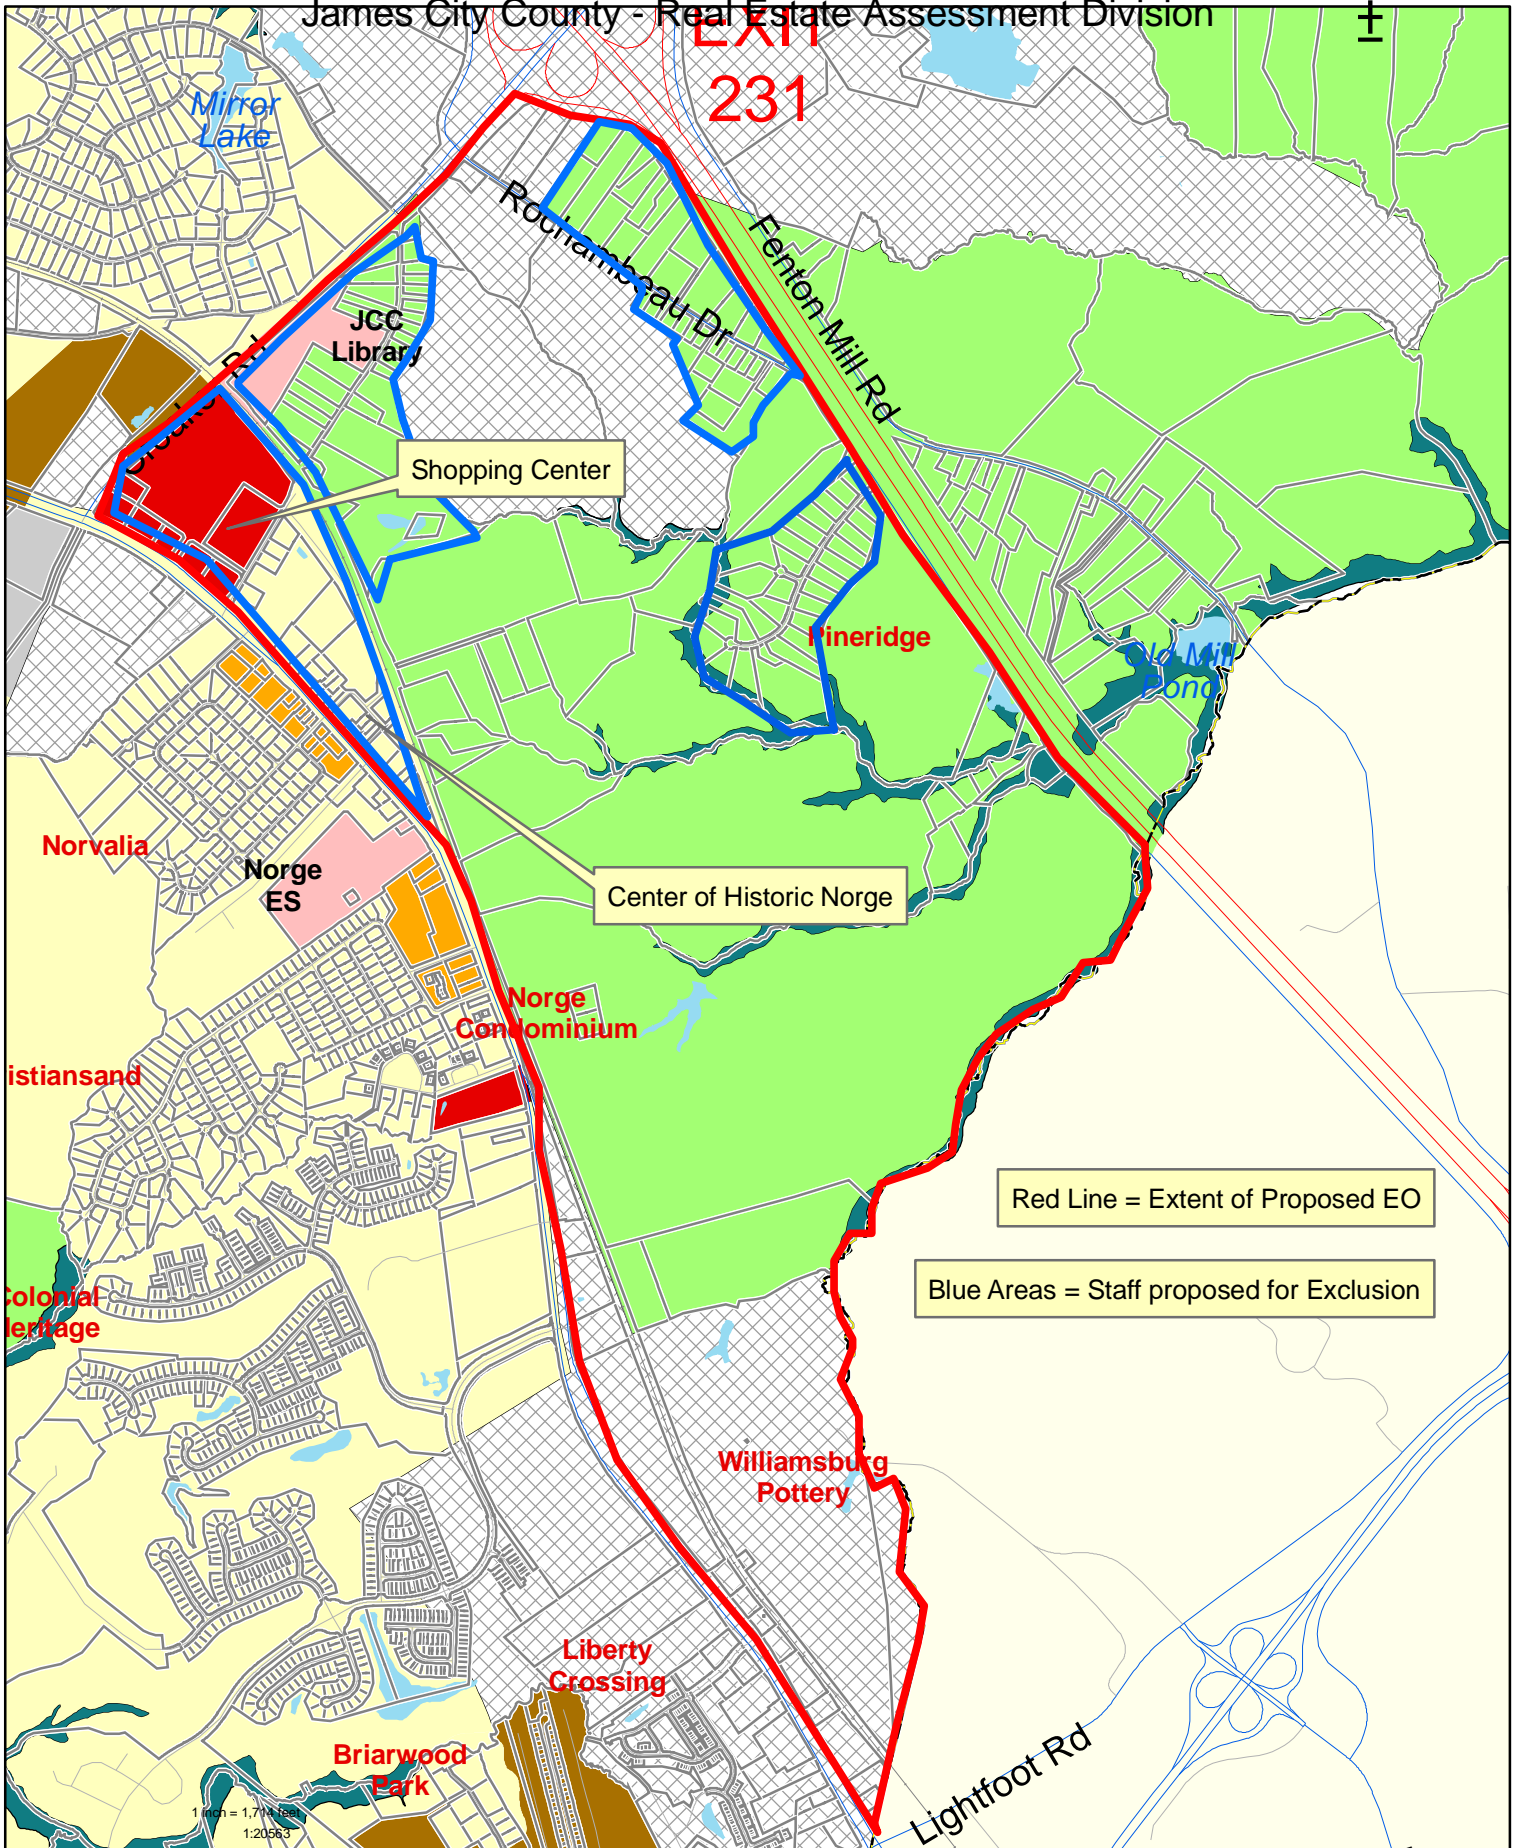

Red Line = Extent of Proposed EO

Blue Areas = Staff proposed for Exclusion

1 inch = 1,714 feet
1:20583

1 inch = 1,714 feet

